



AS BUILT

DO NOT SCALE


- NOTES:
1. ALL DIMENSIONS ARE IN MILLIMETRES AND LEVELS ARE IN METRES.
 2. DO NOT SCALE THE DRAWING FOLLOW ONLY WRITTEN DIMENSIONS.
 3. FOR GENERAL NOTES AND LEGEND REFER TO DRAWING H6543/1655.
 4. FOR DETAILS OF STAIRS AND ROOF SLAB REINFORCEMENT & RAFT H6543/2615
 5. LEVEL VARIES FROM (-) 3.400 CD TO (-) 3.800 CD ALONG LENGTH OF WALL.

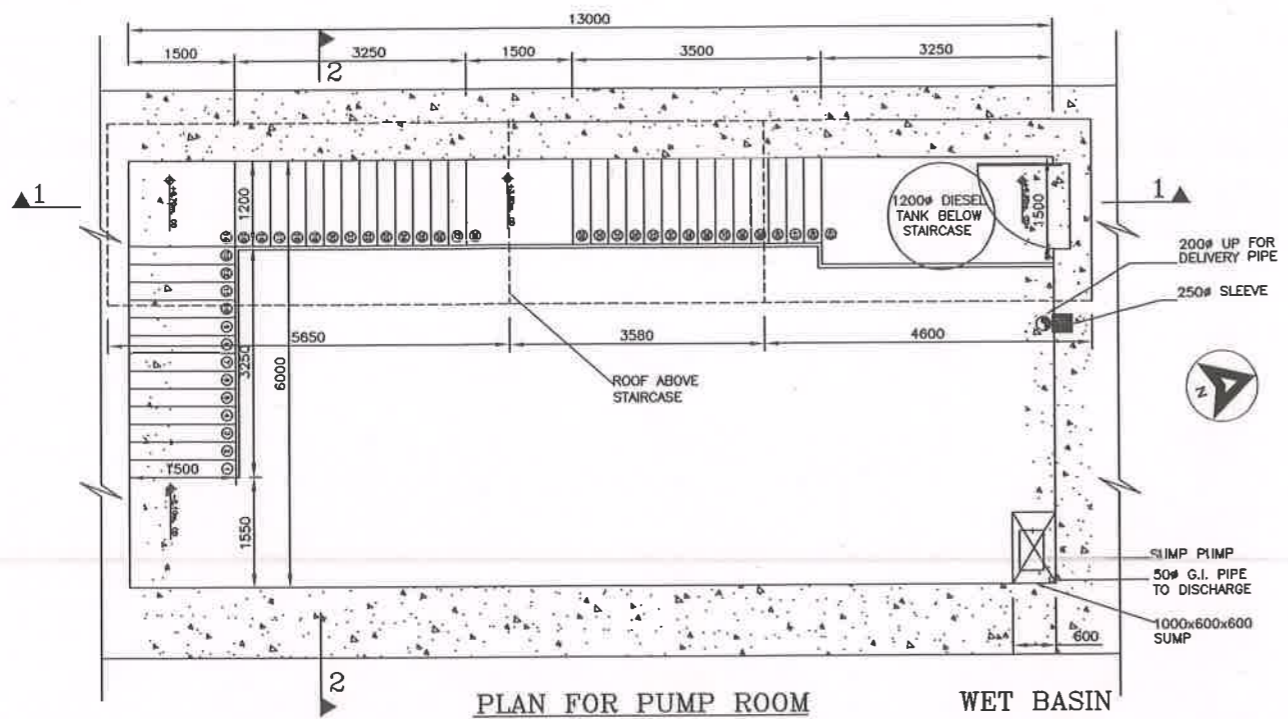

PLAN FOR PUMP ROOM WET BASIN SCALE: 1:50

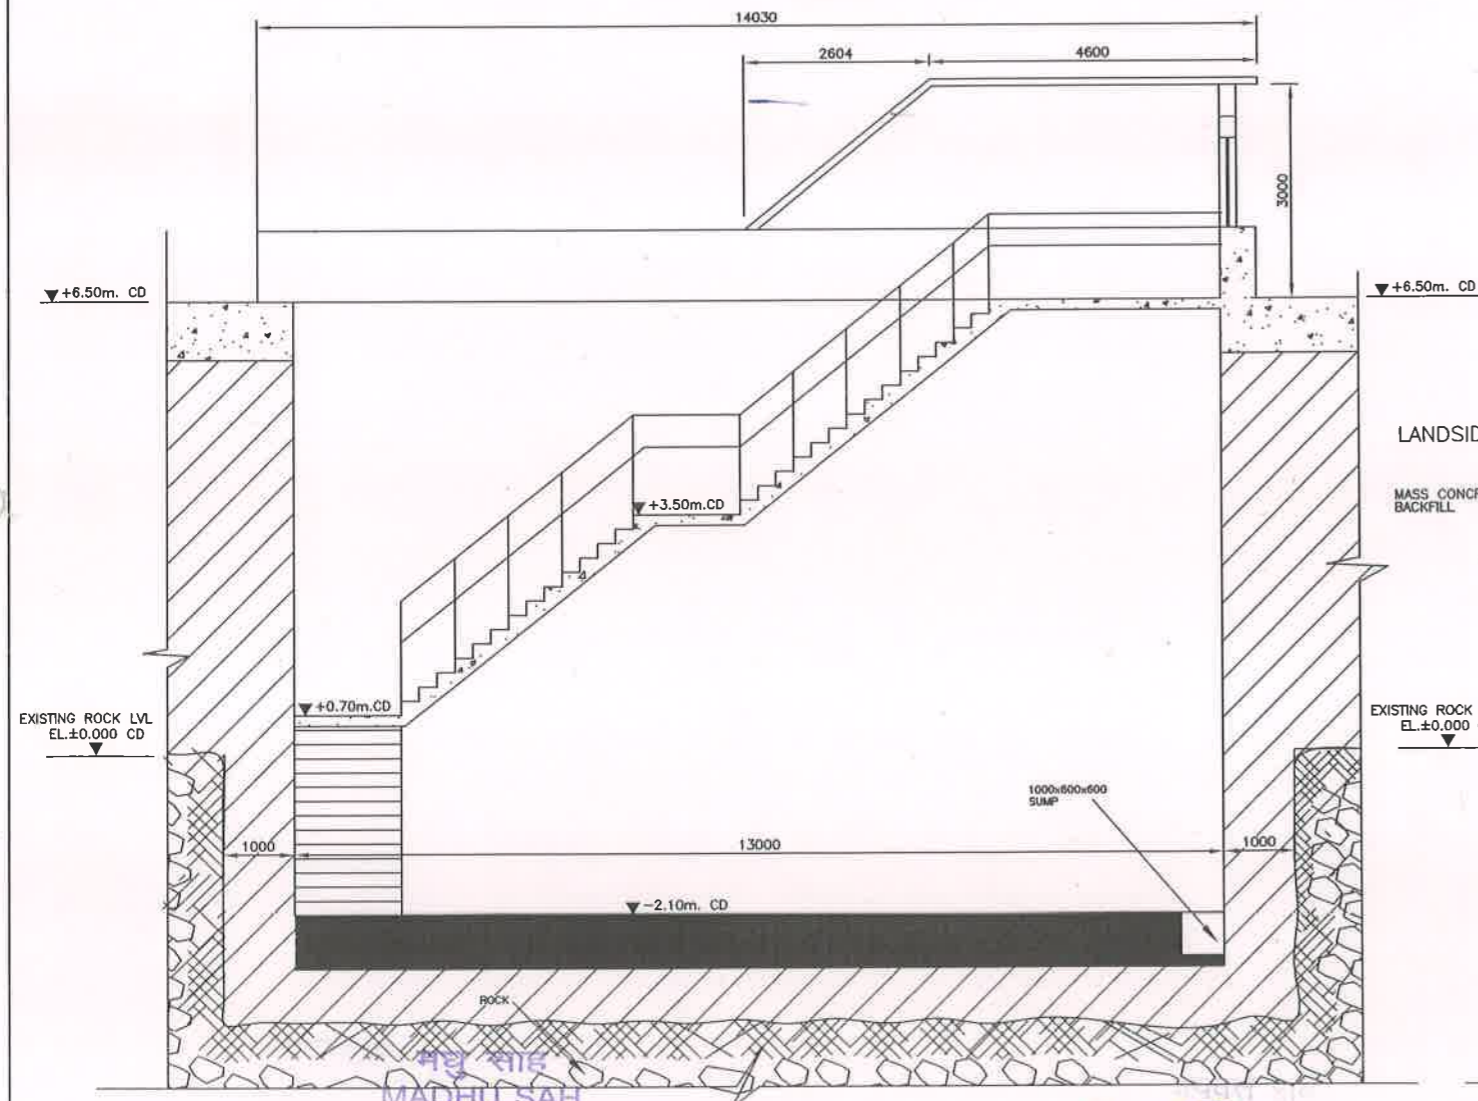

SECTION 1-1 SCALE: 1:50

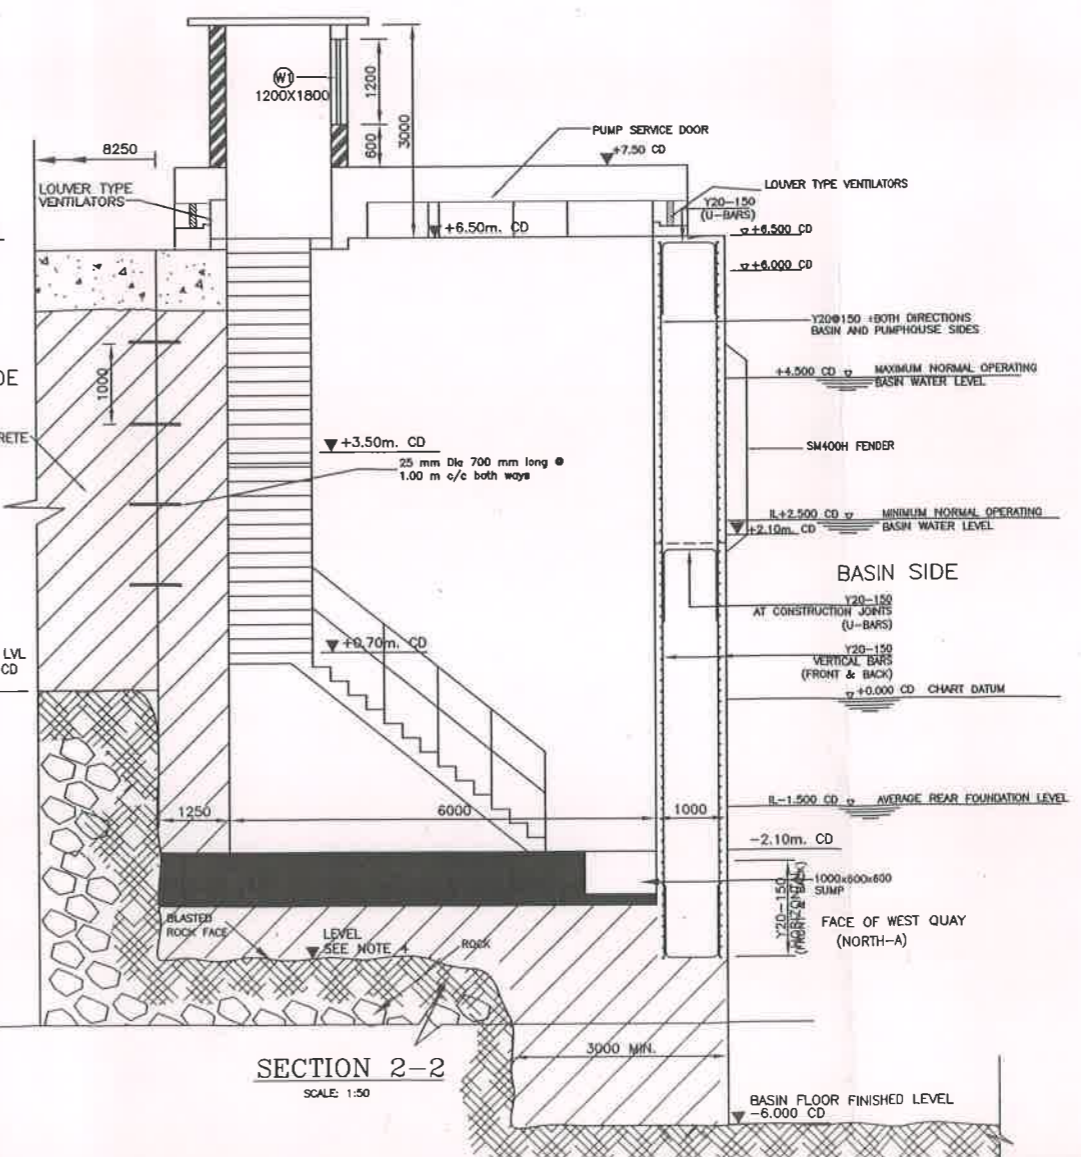

SECTION 2-2 SCALE: 1:50

REV	DATE	DESCRIPTION	BY	CHK	APPD
0	07/12	AS BUILT			

ITDC	
PSI	AND SKG

REVISIONS	

CLIENT	MAZAGON DOCK LTD. DOCKYARD ROAD, MUMBAI - 400 010.
PROJECT	MAZDOCK MODERNISATION PROJECT
DRAWING TITLE	WET BASIN FIRE PUMP HOUSE PLAN & SECTIONS
CONSULTANT	HASKONING NEDERLAND BV NEWCASTLE Maitland House 155 Booth Street Newcastle NSW 1590 Phone: +61 8 081 21 1300 Fax: +61 8 081 21 1313 Email: haskoning@haskoning.com www.haskoning.com
CONTRACTOR	ITD CEMENTATION INDIA LIMITED ALCOCK ROAD, DATE NO. 8 & 9 DOCK YARD ROAD, MUMBAI - 400 010 Phone: +91 22 23341888 Fax: +91 22 23341881 Email: itd@itdce.com Head Office: 10th Floor, 85A, Naraina Complex, Connaught Place, New Delhi - 110 028, India.
JOB CODE	12608AM
DRAWN	P.SAU
DATE	JULY-2012
JOB No.	12608AM
AUTOCAD REF.	H6643/4701
SCALE AT A1	1:75, 1:50
DRAWING No.	H6543/4701
REVISION	G

MADHU SAH
DEPUTY GENERAL MANAGER (Technical Services)
Mazagon Dock Shipbuilders Limited

RAPIND RAO
MAGAZINER TECHNICAL SERVICE
Mazagon Dock Shipbuilders Limited

AS BUILT